


Township N^o XXXVII North. Range N^o III west 2nd Mer.

INDIANA.
N & W 2 P. M.

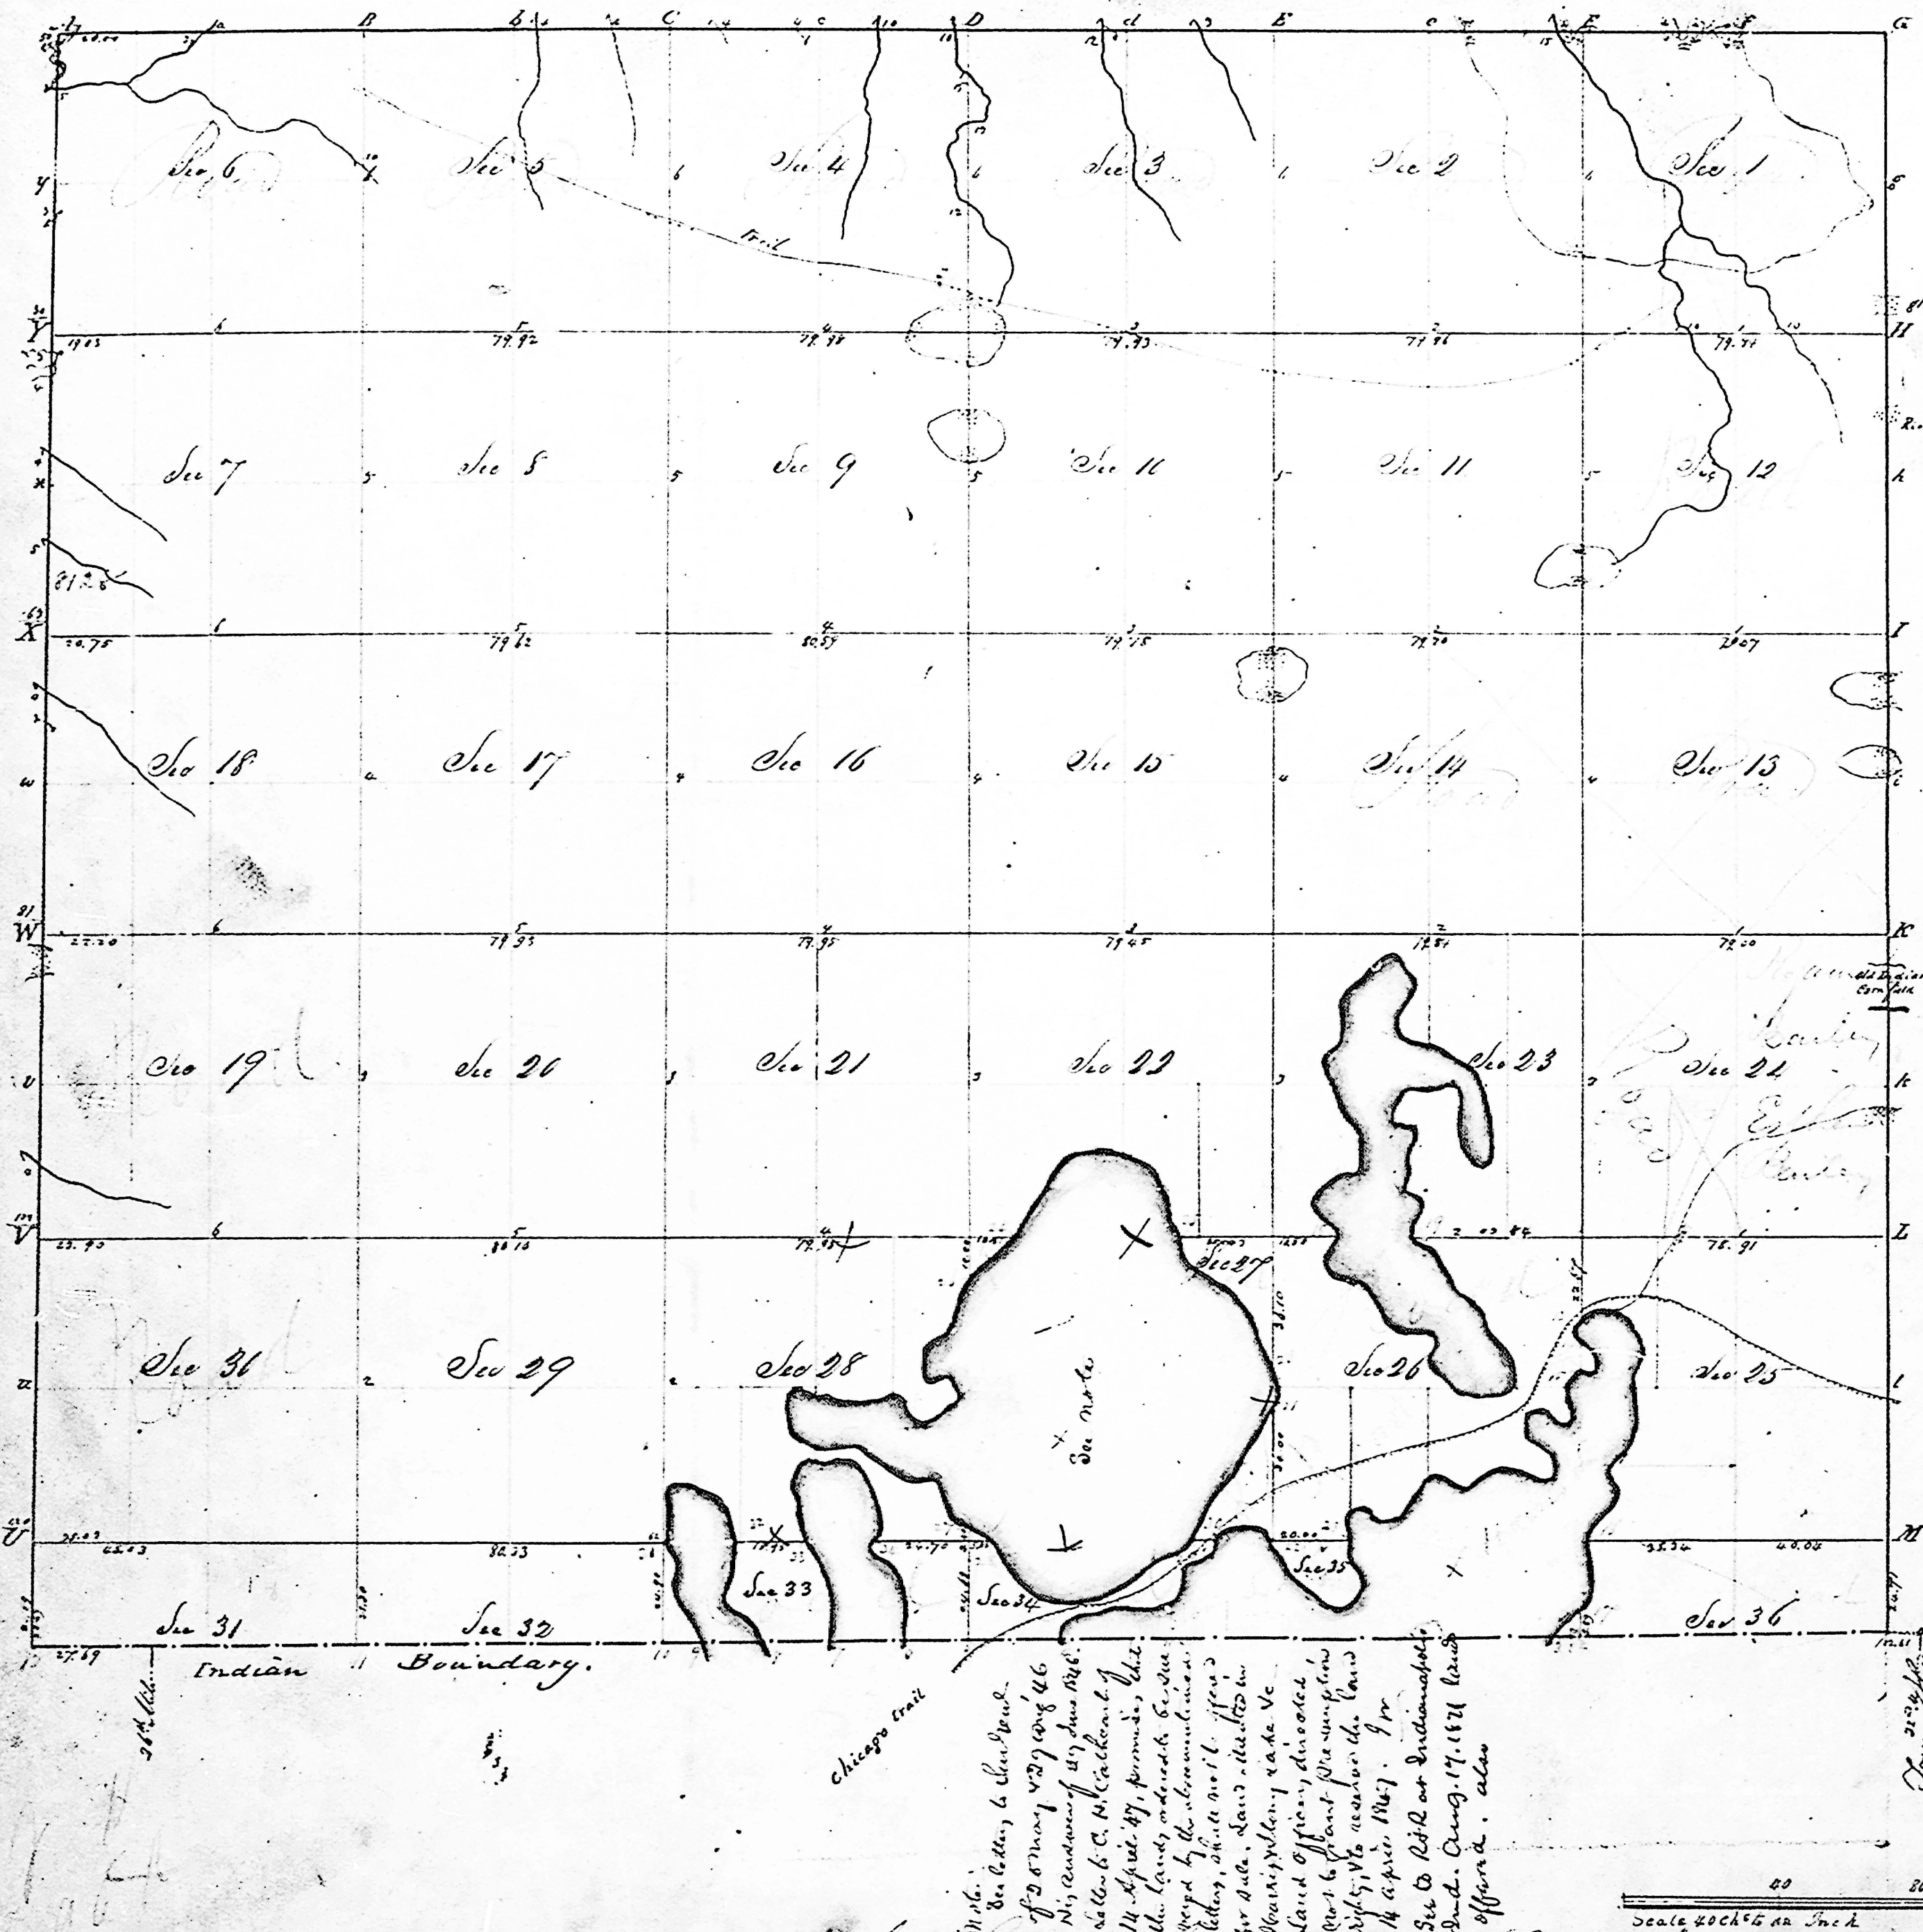

Contents			Contents		
Sections	Acres	Ad	Sections	Acres	Ad
Sec 1	640		E. p. NW 20	107 1/2	
2	640		W. p. SE 16	113 3/4	
3	640		E. p. SW	17 1/2	
4	640		W. p. SW	10 1/2	
5	640		W. p. NW	79 25	
6	320		SE	40 1/2	
E. p. NW	80		SW	550	
W. p. NW	79 1/2		SE	32 75	
E. p. SW	80		SW	186	
W. p. SW	77 1/2		E. p. SE 28	82 1/2	
E. p. NW	320		W. p. NW	95 20	
W. p. NW	80		SW	160	
E. p. SW	80		SE	30 10	
W. p. SW	81 3/4 x 27 28		E. p. SW	61 50	
Sec 8	640		W. p. SW	57 70	
9	640		Sec 29	640	
10	640		E. p. SW	320	
11	640		E. p. NW	80	
12	640		W. p. NW	96 73	
13	640		E. p. SW	80	
14	640		W. p. SW	98 99	
15	640		E. p. SW	110 10	
16	640		W. p. SW	111 85	
17	640		E. p. SW	101 28	
18	320		W. p. SW	101 09	
E. p. NW	80		E. p. NW	46 05	
W. p. NW	84 45		W. p. NW	61 53	
E. p. SW	80		W. p. NW	9 66	
W. p. SW	87 35		W. p. NW	60 96	
E. p. NW	320		W. p. NW	25 66	
W. p. NW	80		E. p. NW	20 8	
E. p. NW	90 50		W. p. NW	98 33	
E. p. SW	80		W. p. NW	92 24	
W. p. SW	93 90			3115 64	
Sec 20	640			1575 629	
21	640			18871 93	
E. p. NW	320				
E. p. SE	80				
W. p. SE	69 90				
E. p. NW	112 70				
E. p. NW	80				
W. p. NW	72				
E. p. SE	100 64				
W. p. SE	80				
W. p. NW	85 00				
W. p. NW	70 00				
Sec 24	640				
E. p. NW	320				
E. p. NW	80				
W. p. NW	57 10				
N. p. NW	53 56				
S. p. NW	63 95				
	1575 629				

Surveyed in December 1829 by Thomas Henderson D. S.


A true copy of the original plat filed in this office
Surveyor General's Office
1. April 1830.

Wm. S. S. S.

IND

Copy sent to Register at Indianapolis March 23. 1860. in order that lot N^o 2. of Sec 35. be disposed of according to such future instructions as the Comm^r may give.
 Copy sent to the Gov^t of Indiana " " "

Township 37 N.R. 3 West 2nd Mer. Indiana.

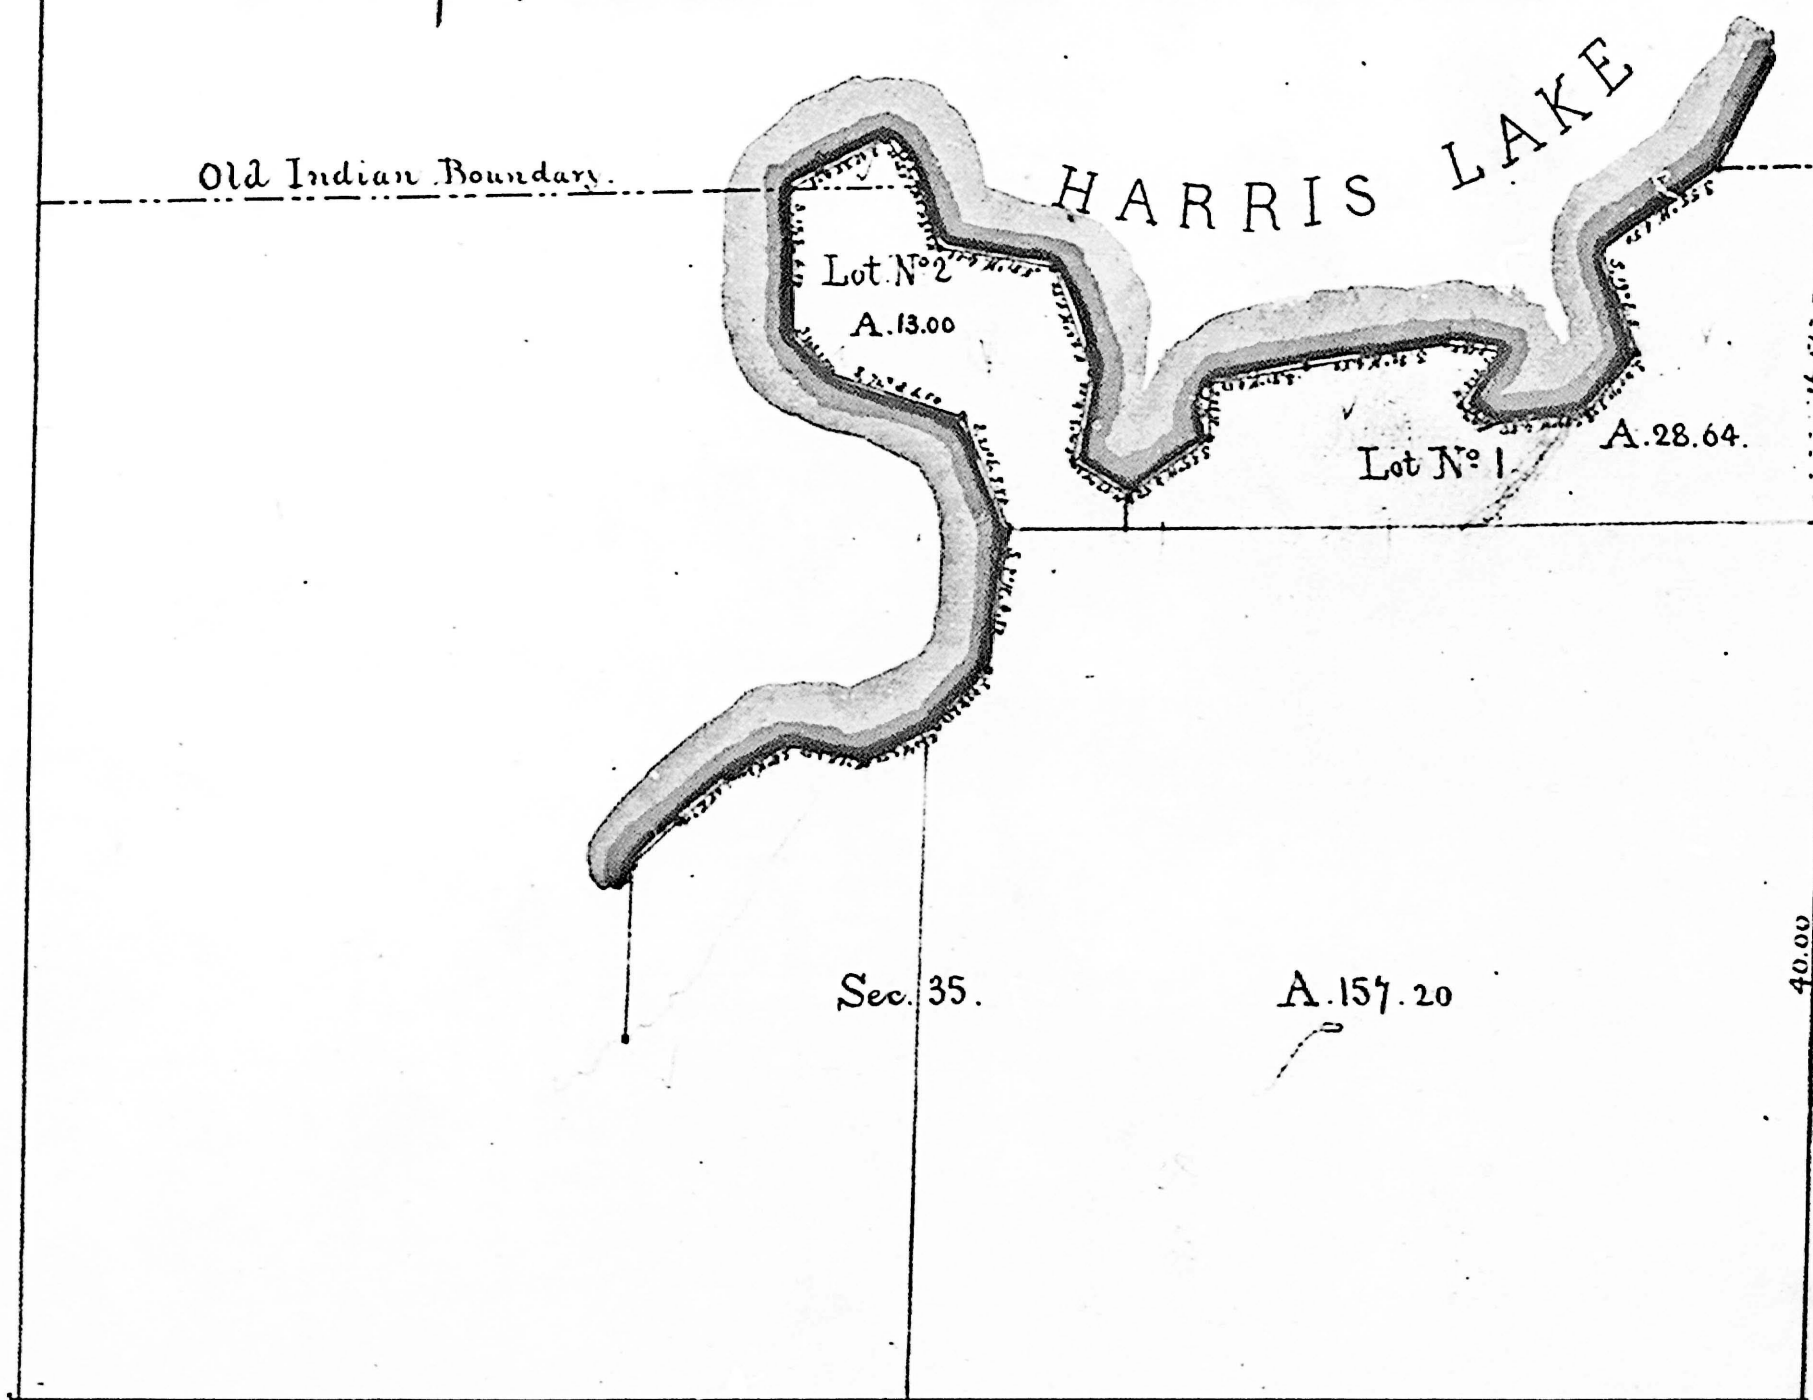

INDIANA.
 N. & W. 2. P. M.


General Land Office
 March 21st 1860

I hereby certify that the above is a plat protracted at this office from the field notes of the resurvey of Lot N^o 1. (south of the old Ind. Boundary) in Section 35, T. 37. N. R. 3. W. of the 2nd Mer. Ind. - and that Lot N^o 2, of said Diagram, being formed as a separate parcel of land by the reception of the waters since the original survey, the field notes above mentioned of this latter parcel are held to be the returns, to that extent, of an original survey: and pursuant to the Act of 22nd January 1853, the said plat, and the field notes from which it was constructed, are hereby approved.

[Signature]
 Commissioner & Ex Officio
 Surveyor General of Indiana

[Indiana]

Township 37 N. R. 3 West 2nd Mer. Indiana.

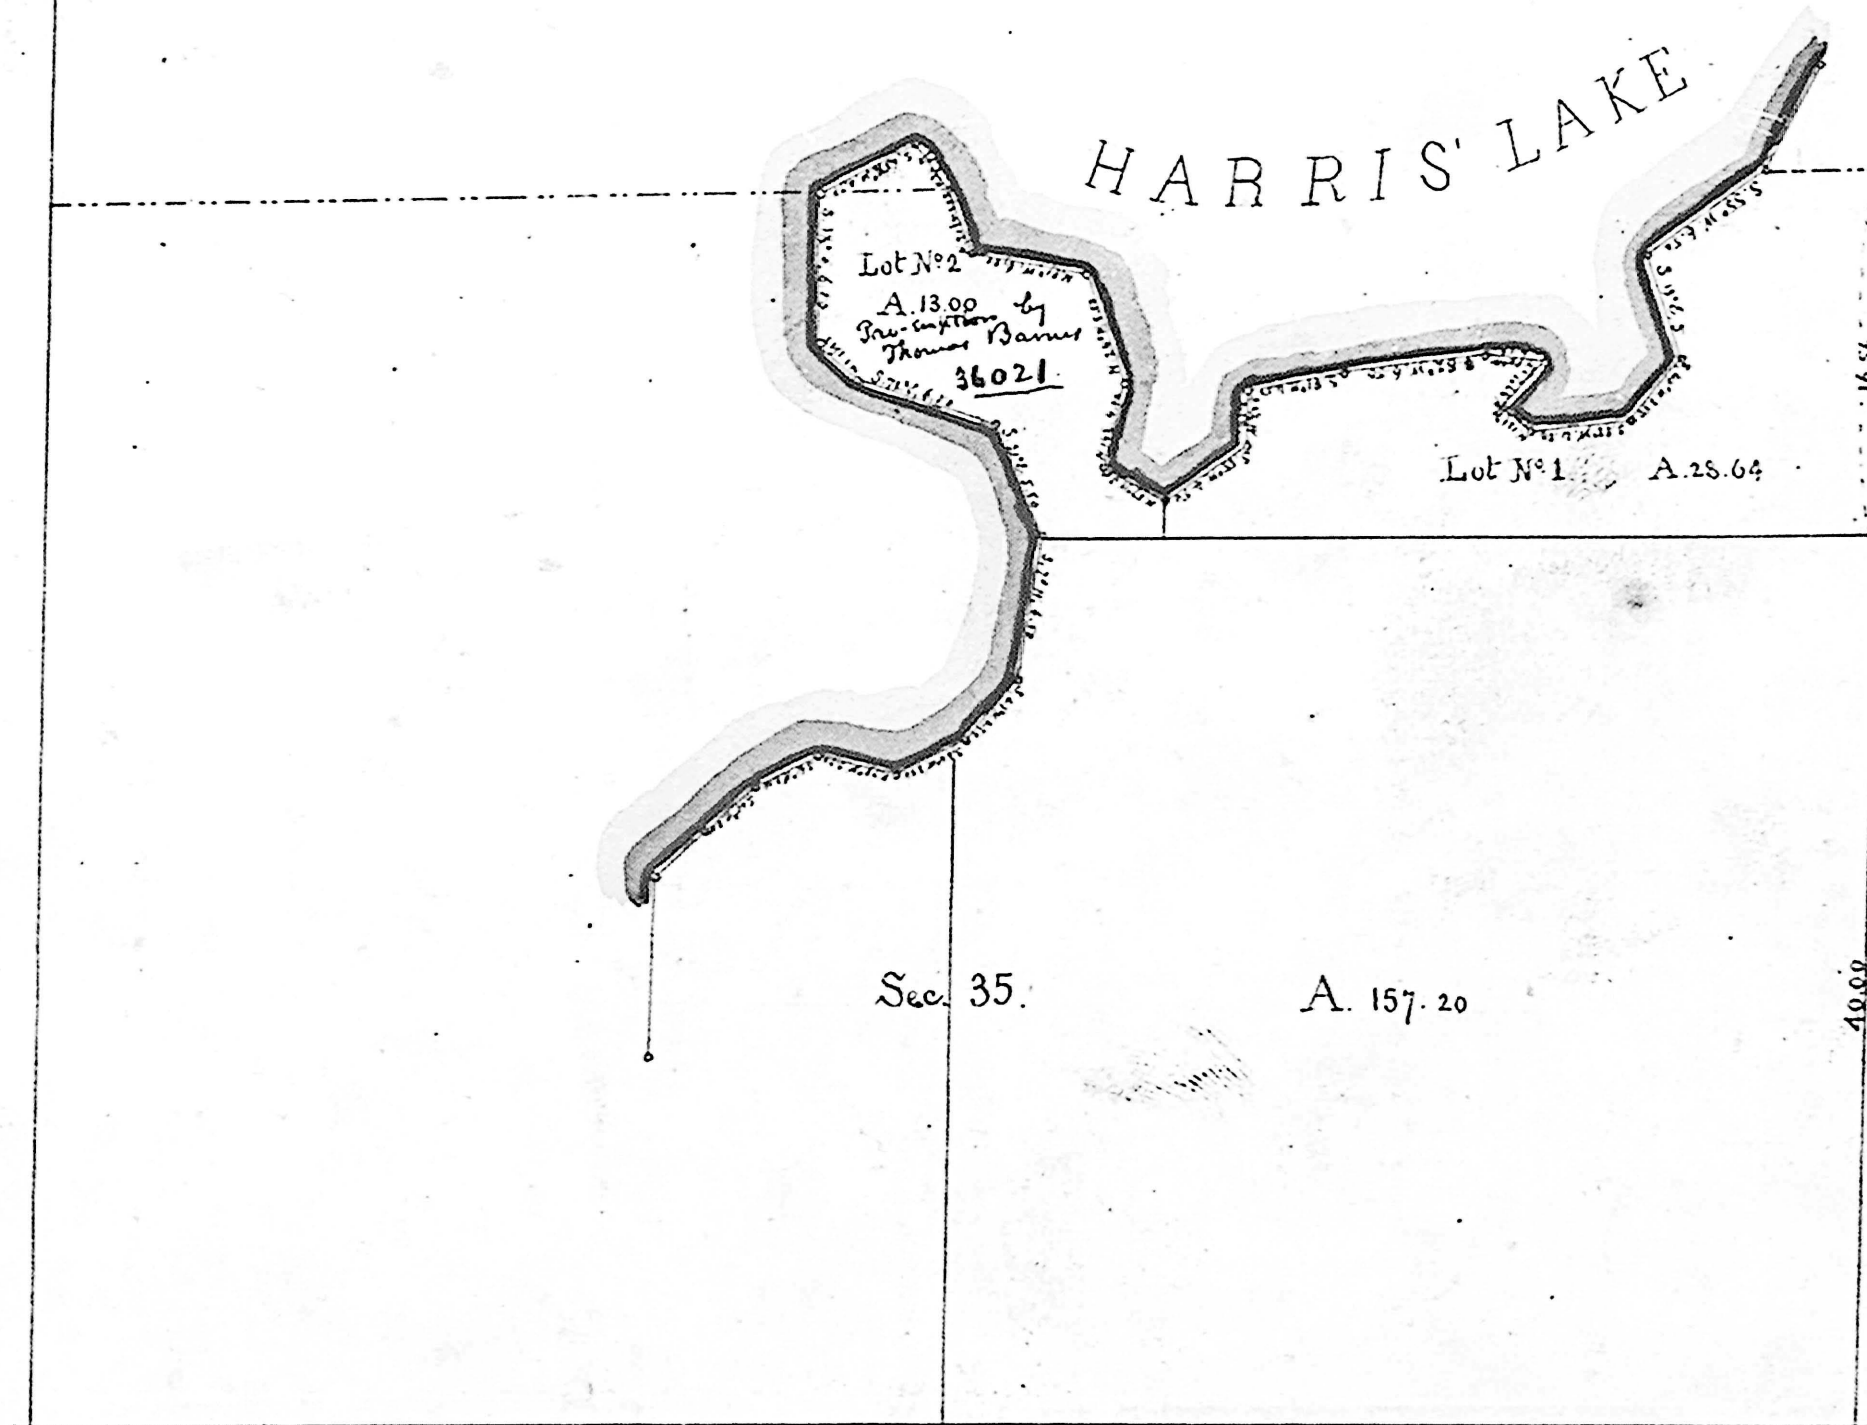


General Land Office
March 21st 1860

I hereby certify that the above is a plat protracted at this Office from the field notes of the resurvey of Lot No. 1, South of the old Ind. Boundary, in Section 35. T. 37. N. R. 2. W. of the 2nd Mer. Ind. - and that Lot No. 2. of said Diagram, being formed as a separate parcel of land by the reception of the waters since the original survey, the field notes above mentioned of this latter parcel are held to be the returns, to that extent, of an original survey; and pursuant to the act of 22nd January 1853, the said plat, and the field notes from which it was constructed, are hereby approved.

Wm. Nelson
Commissioner & Ex officio
Surveyor General of Indiana

Township 37 N. R. 3 West 2nd Mer. Indiana.

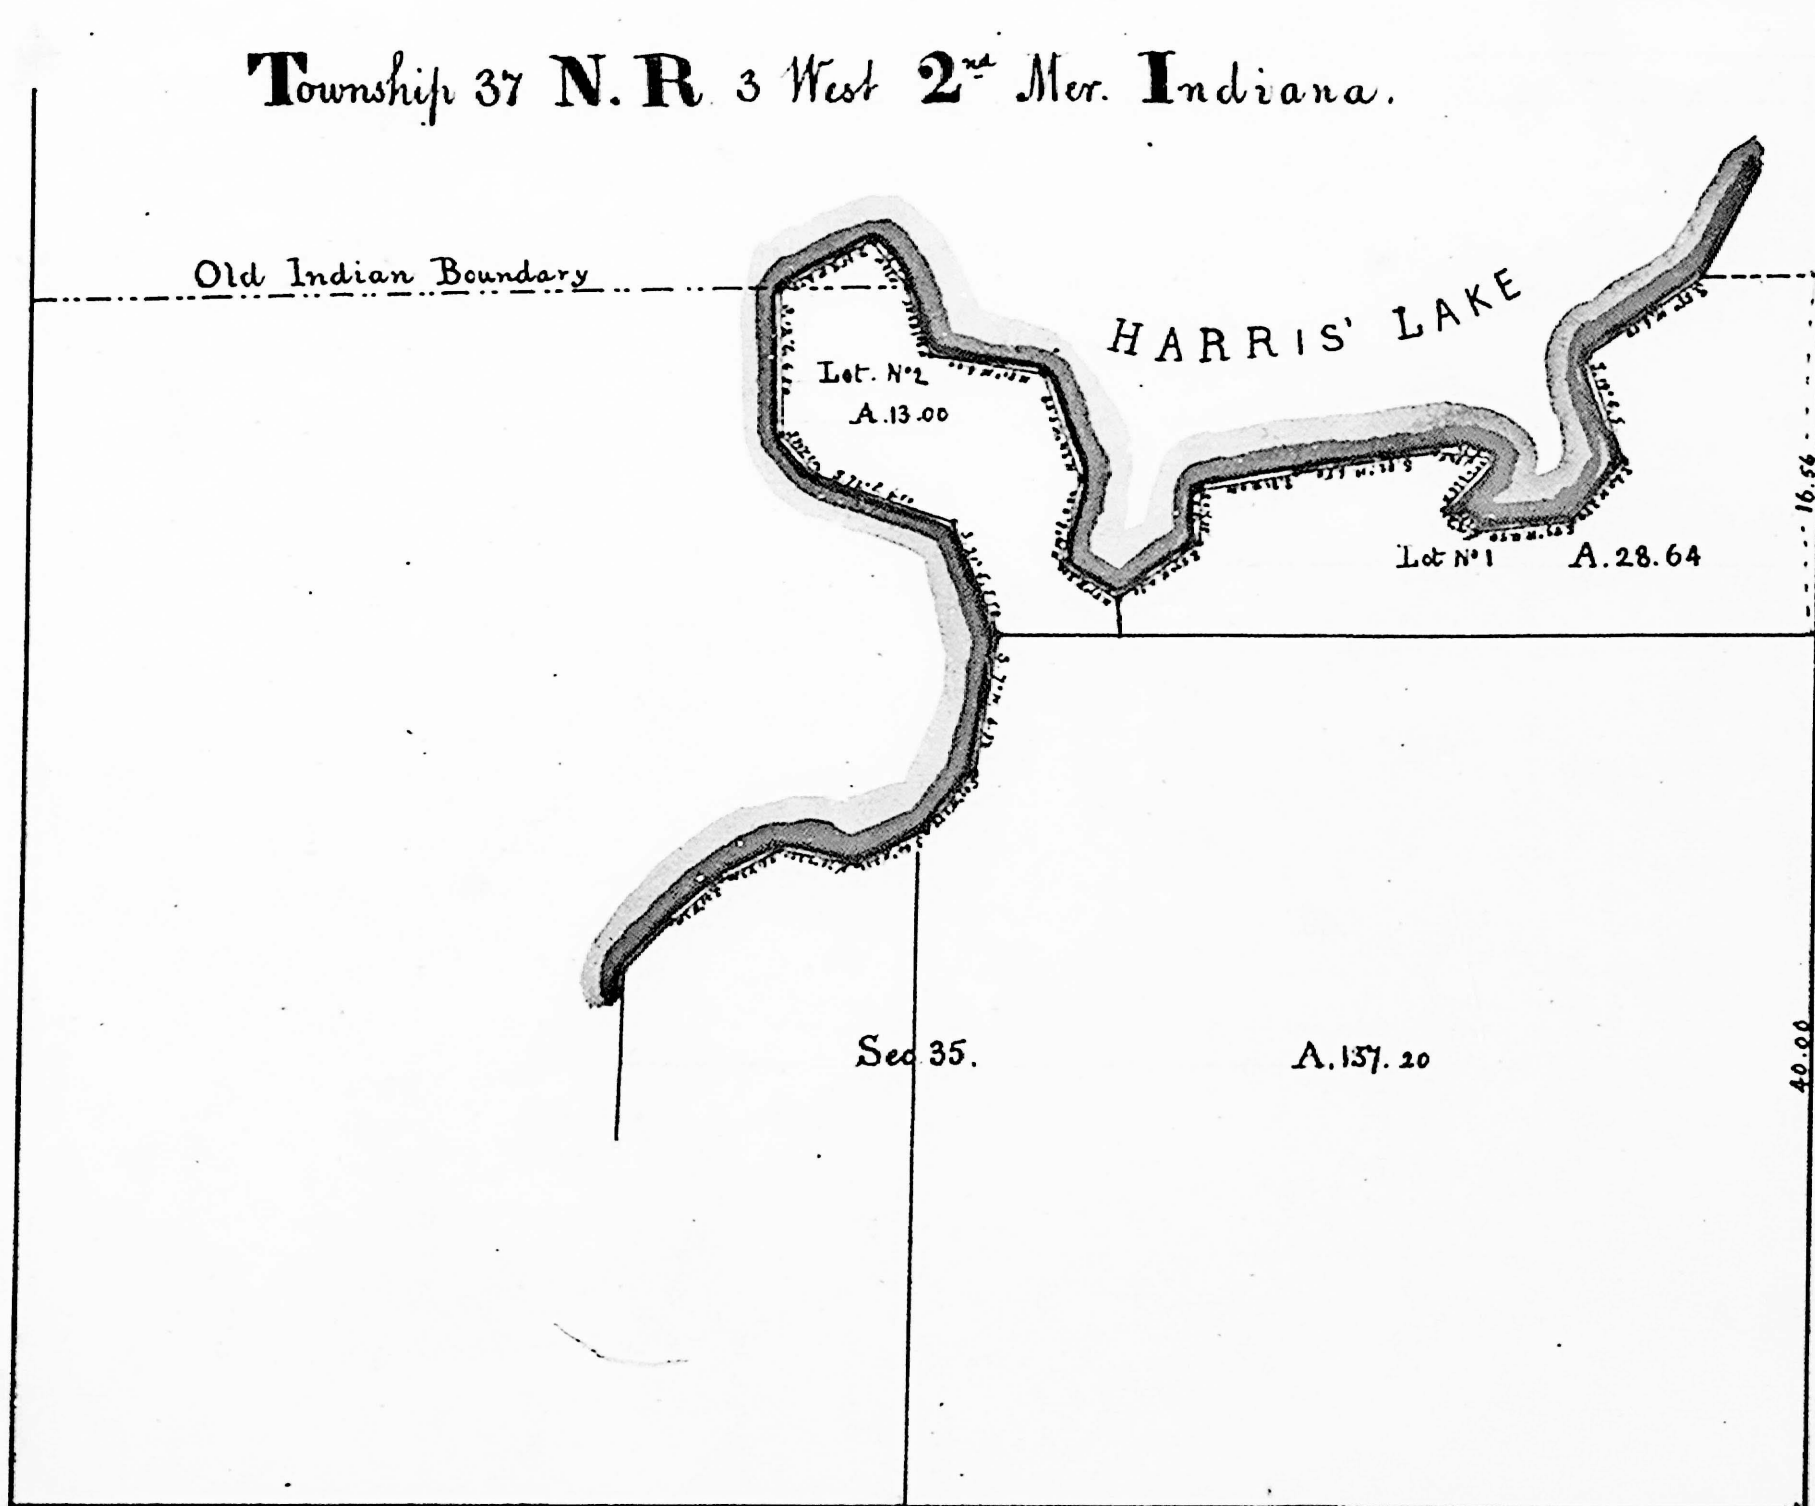

General Land Office
March 21st 1860

I hereby certify that the above is a plat constructed at this office from the field notes of the resurvey of Lot No. 1. (South of the Old Ind. Boundary) of Section 35. T. 37. N. R. 3. W. 2. mer. of Ind. - and that Lot No. 2 of said Diagram, being formed as a separate parcel of land by the reception of the waters since the original survey, the field notes above mentioned of this latter parcel are held to be the returns, to that extent, of an original survey, and pursuant to the Act of 22nd January 1853, the said plat, and the field notes from which it was constructed, are hereby approved.

[Signature]
Commissioner & Ex officio
Surveyor General of Indiana

707
Ind


IND

See section 11, page 1
 copy sent to R & R at Indian Shovel End.
 Aug. 17. 1871

D. 31. 1. 46 31. 2 11 Indian
 Res. July 28 1871

See to Sec. Genl. May 20. 1846.

" " " 12. 1847 Lands by the survey shown by red line must now be taken by Congress.
 " from " June 29 1846
 " to " " 29 1846 ordering survey of Pine, Harris & Stony Lakes
 " to R & R at Winona Apr 14 1847 to withhold from survey of any part of the lands shown by red line
 " " Hon. C. W. Cathead " 25 " to transmit this diagram for Justice
 " for Sec. Genl.
 See plat of the Lakes approved by Sec. Genl. April 27 1847.
 See to Command. F. Jenkins. Red line this June 9 1876.

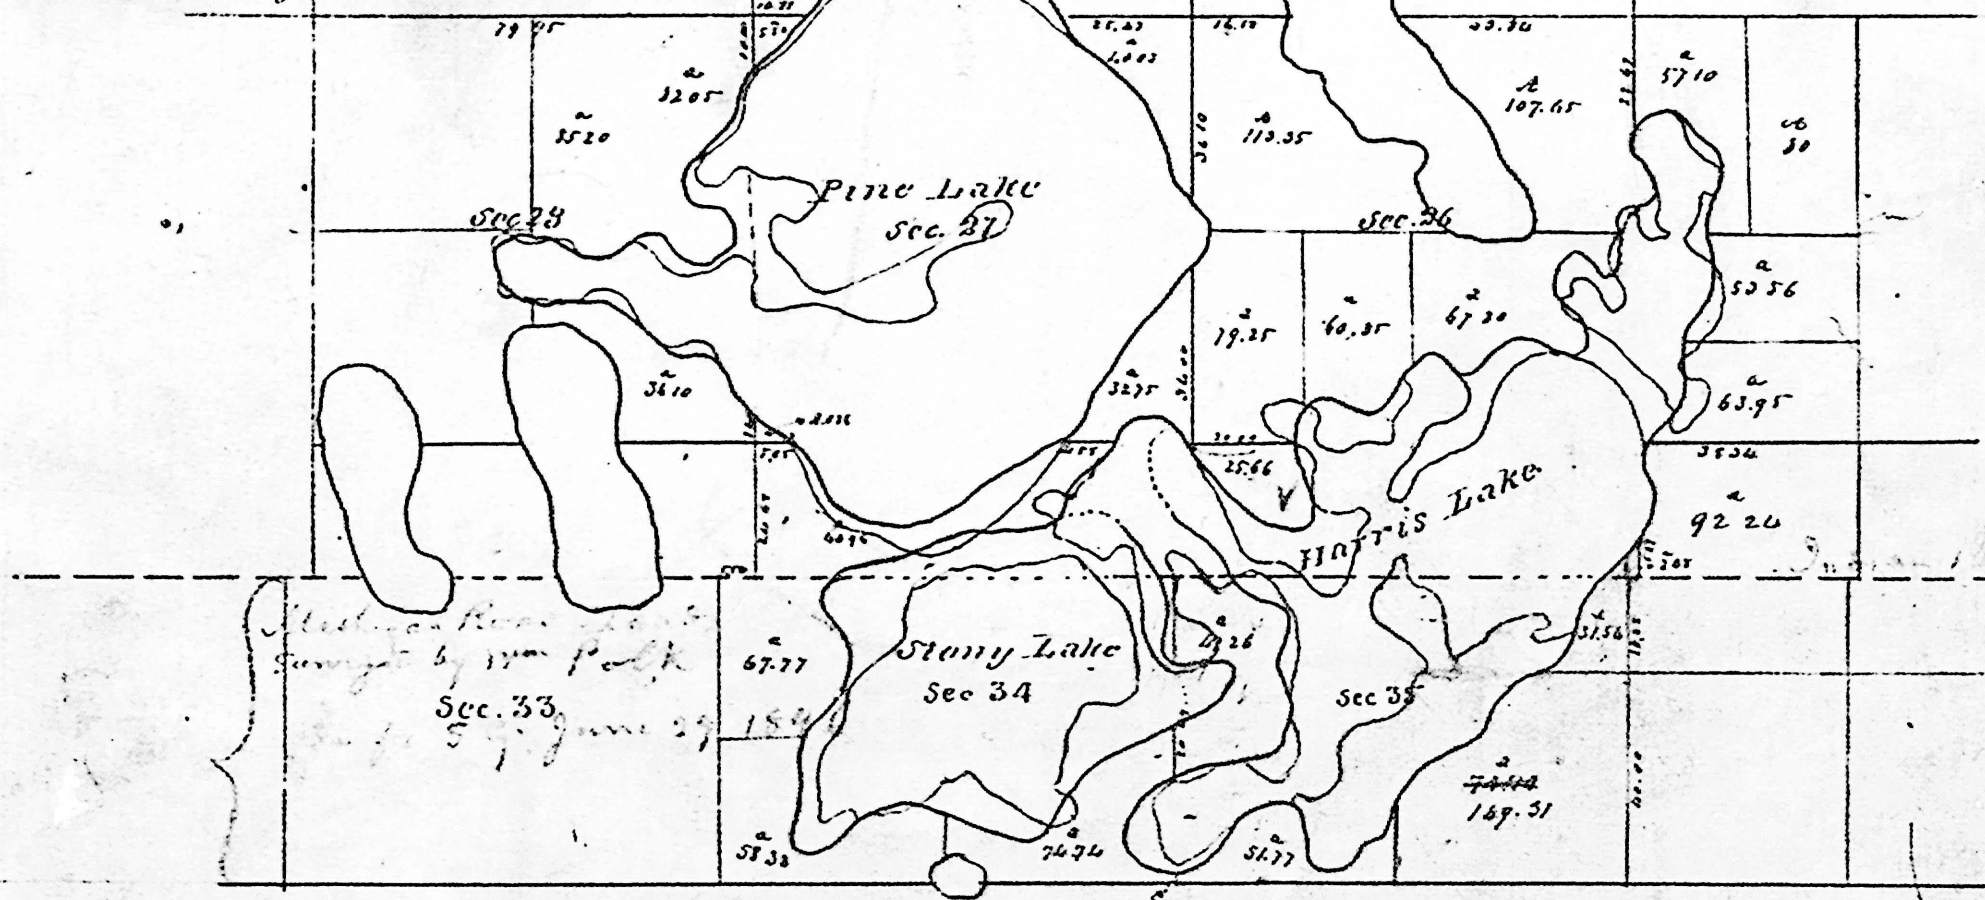


The above Diagram is a copy from the recorded
 plat now in the surveyor's office at Detroit.
 The lines in red show the reservation by claim of
 the Harris and Stony lakes.

IND

Township N^o XXXVII N., R. N^o III W. 2nd Mer. 1nd.

Copy of this plat sent to the R & R at Indianapolis, Ind. August 17th 1871.
" recalled from the files of the Register Oct 16 1871.

* See letter to J. B. Kiles and R. R. Nov 18 1871.

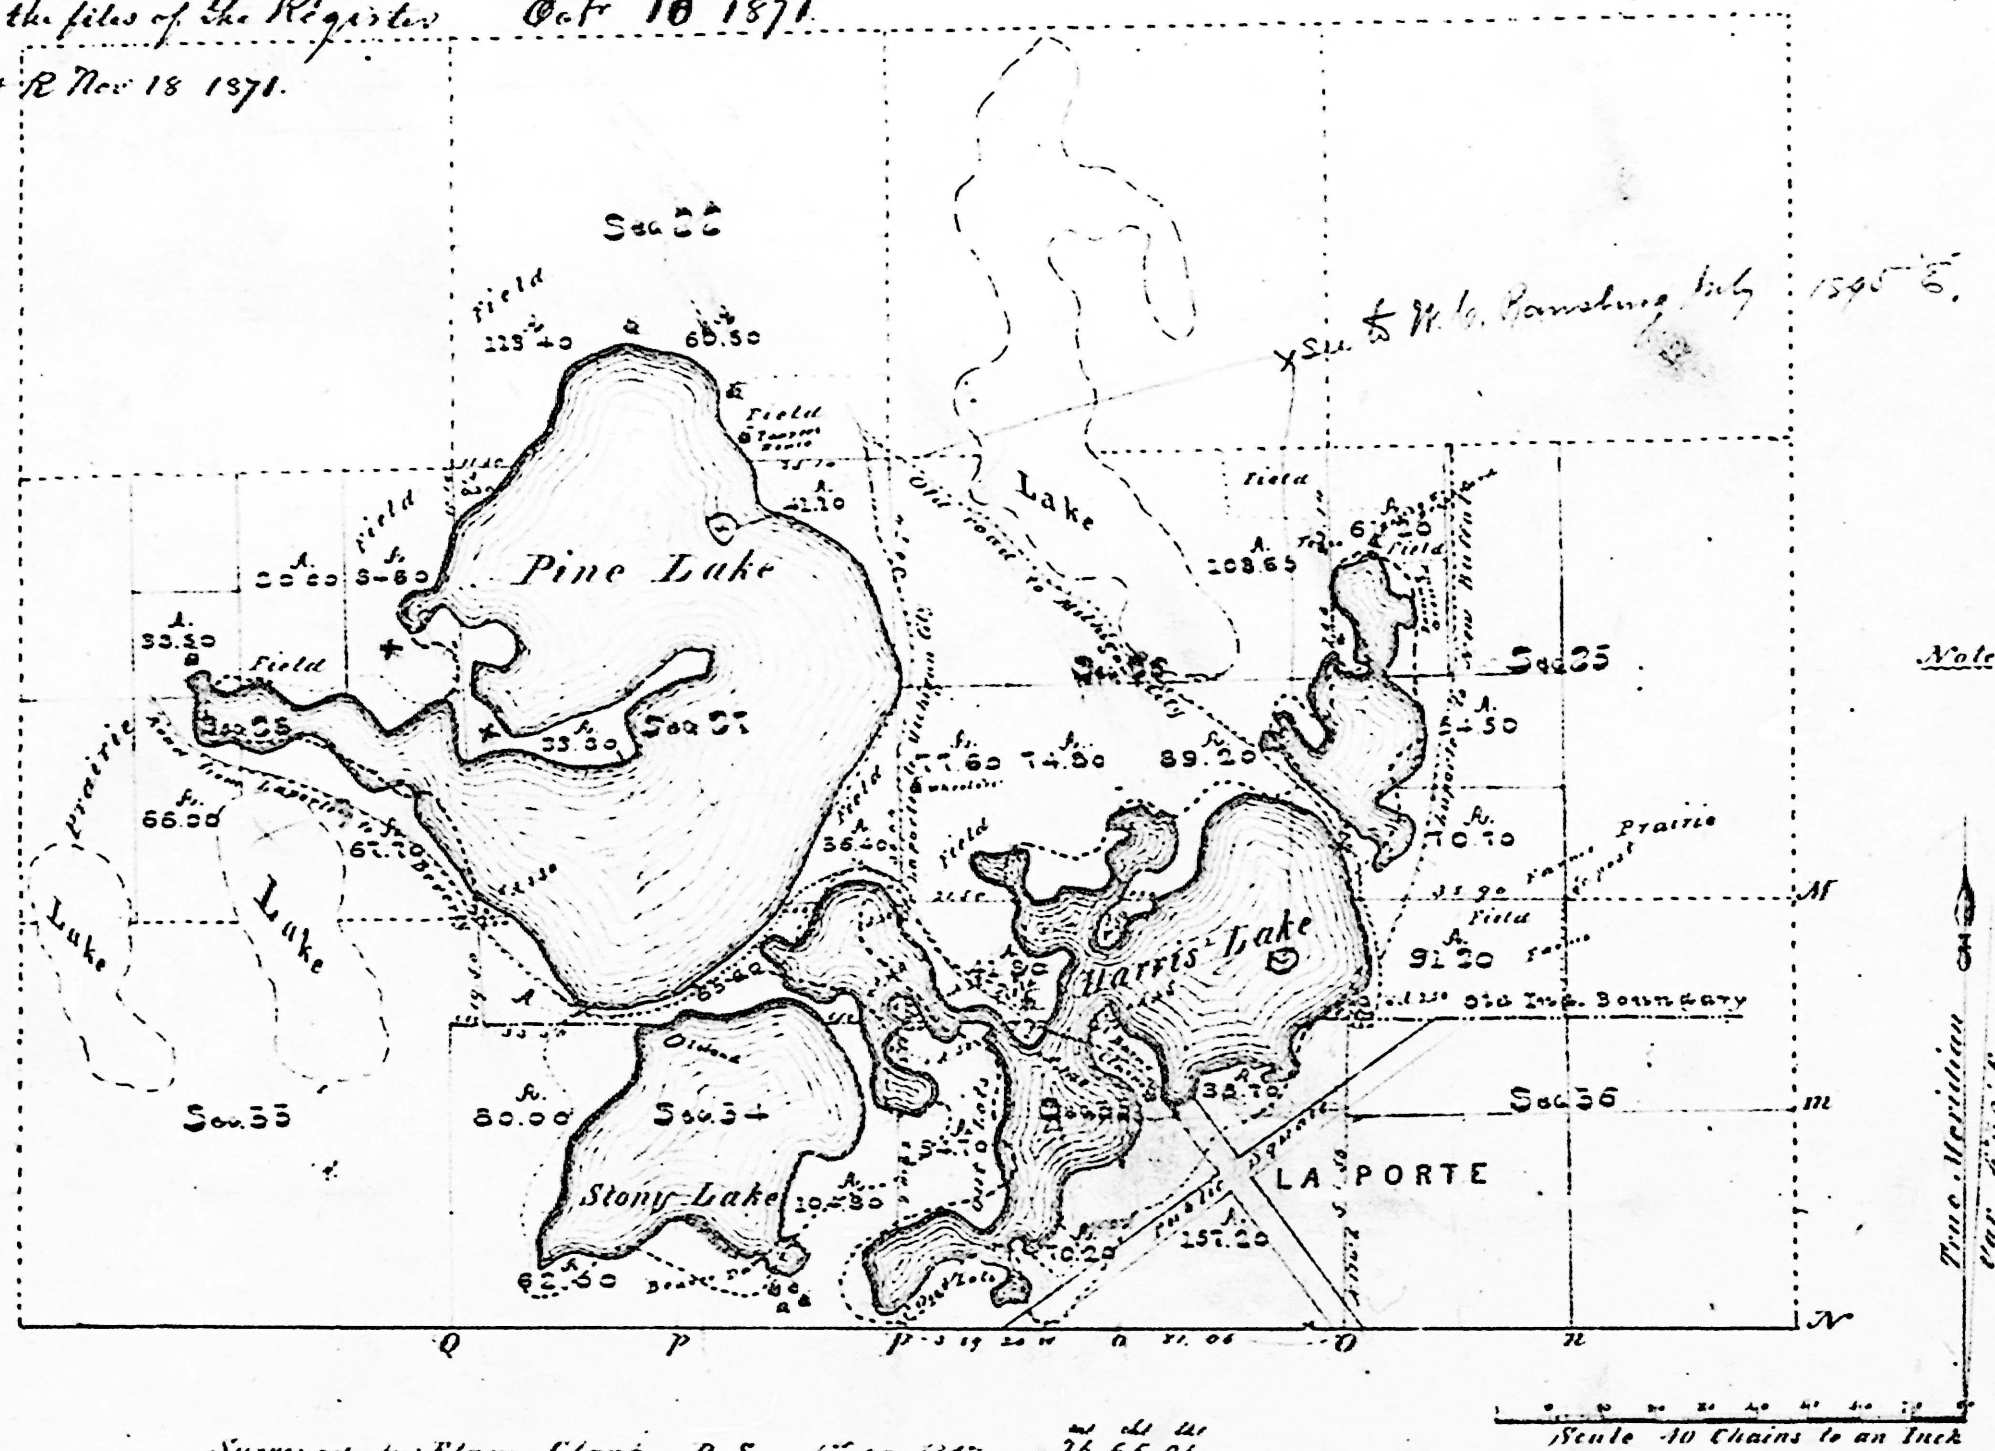

Surrender by Elam Clark D.S. 1st of 1847 26 65.96

The above diagram of a part of T. 37 N., R. 37 E. of the 2nd P. Meridian Indiana, is strictly conformable to the field notes of the survey thereof, on file in this office, which have been examined and approved; the said survey having been made in accordance with instructions from the Commissioner of the General Land Office of 29th August 1845.

Surveyor General's Office,
Detroit April 27th 1847

Lucius Lyon,
Sur. Gen.

Invoice paid for 12 May 1847
for W. L. affix Report N^o 426

* Any trace of New Land in this plot to be withheld from sales
see letter from C. M. Collier 21 Feb. 47 and
Circular letter in reply of 14 Feb. 47. Especially with
reference to the opinions of W. M. Mendenhall same date.


RMD

12

The Guide under the surveying are at once subject to the operation of the homestead and pre-emption laws as after due notice by the local land officer, pursuant to instructions from the Commissioner of the General Land Office as contemplated by Section 5 Act of Aug. 3 1846. may be sold for cash to the highest bidder, or if not disposed of in this way will then become subject to private entry, warrant or scrip location.

[enclosed]

Township No 37 N. R No 3 W 2nd Mer Ind.

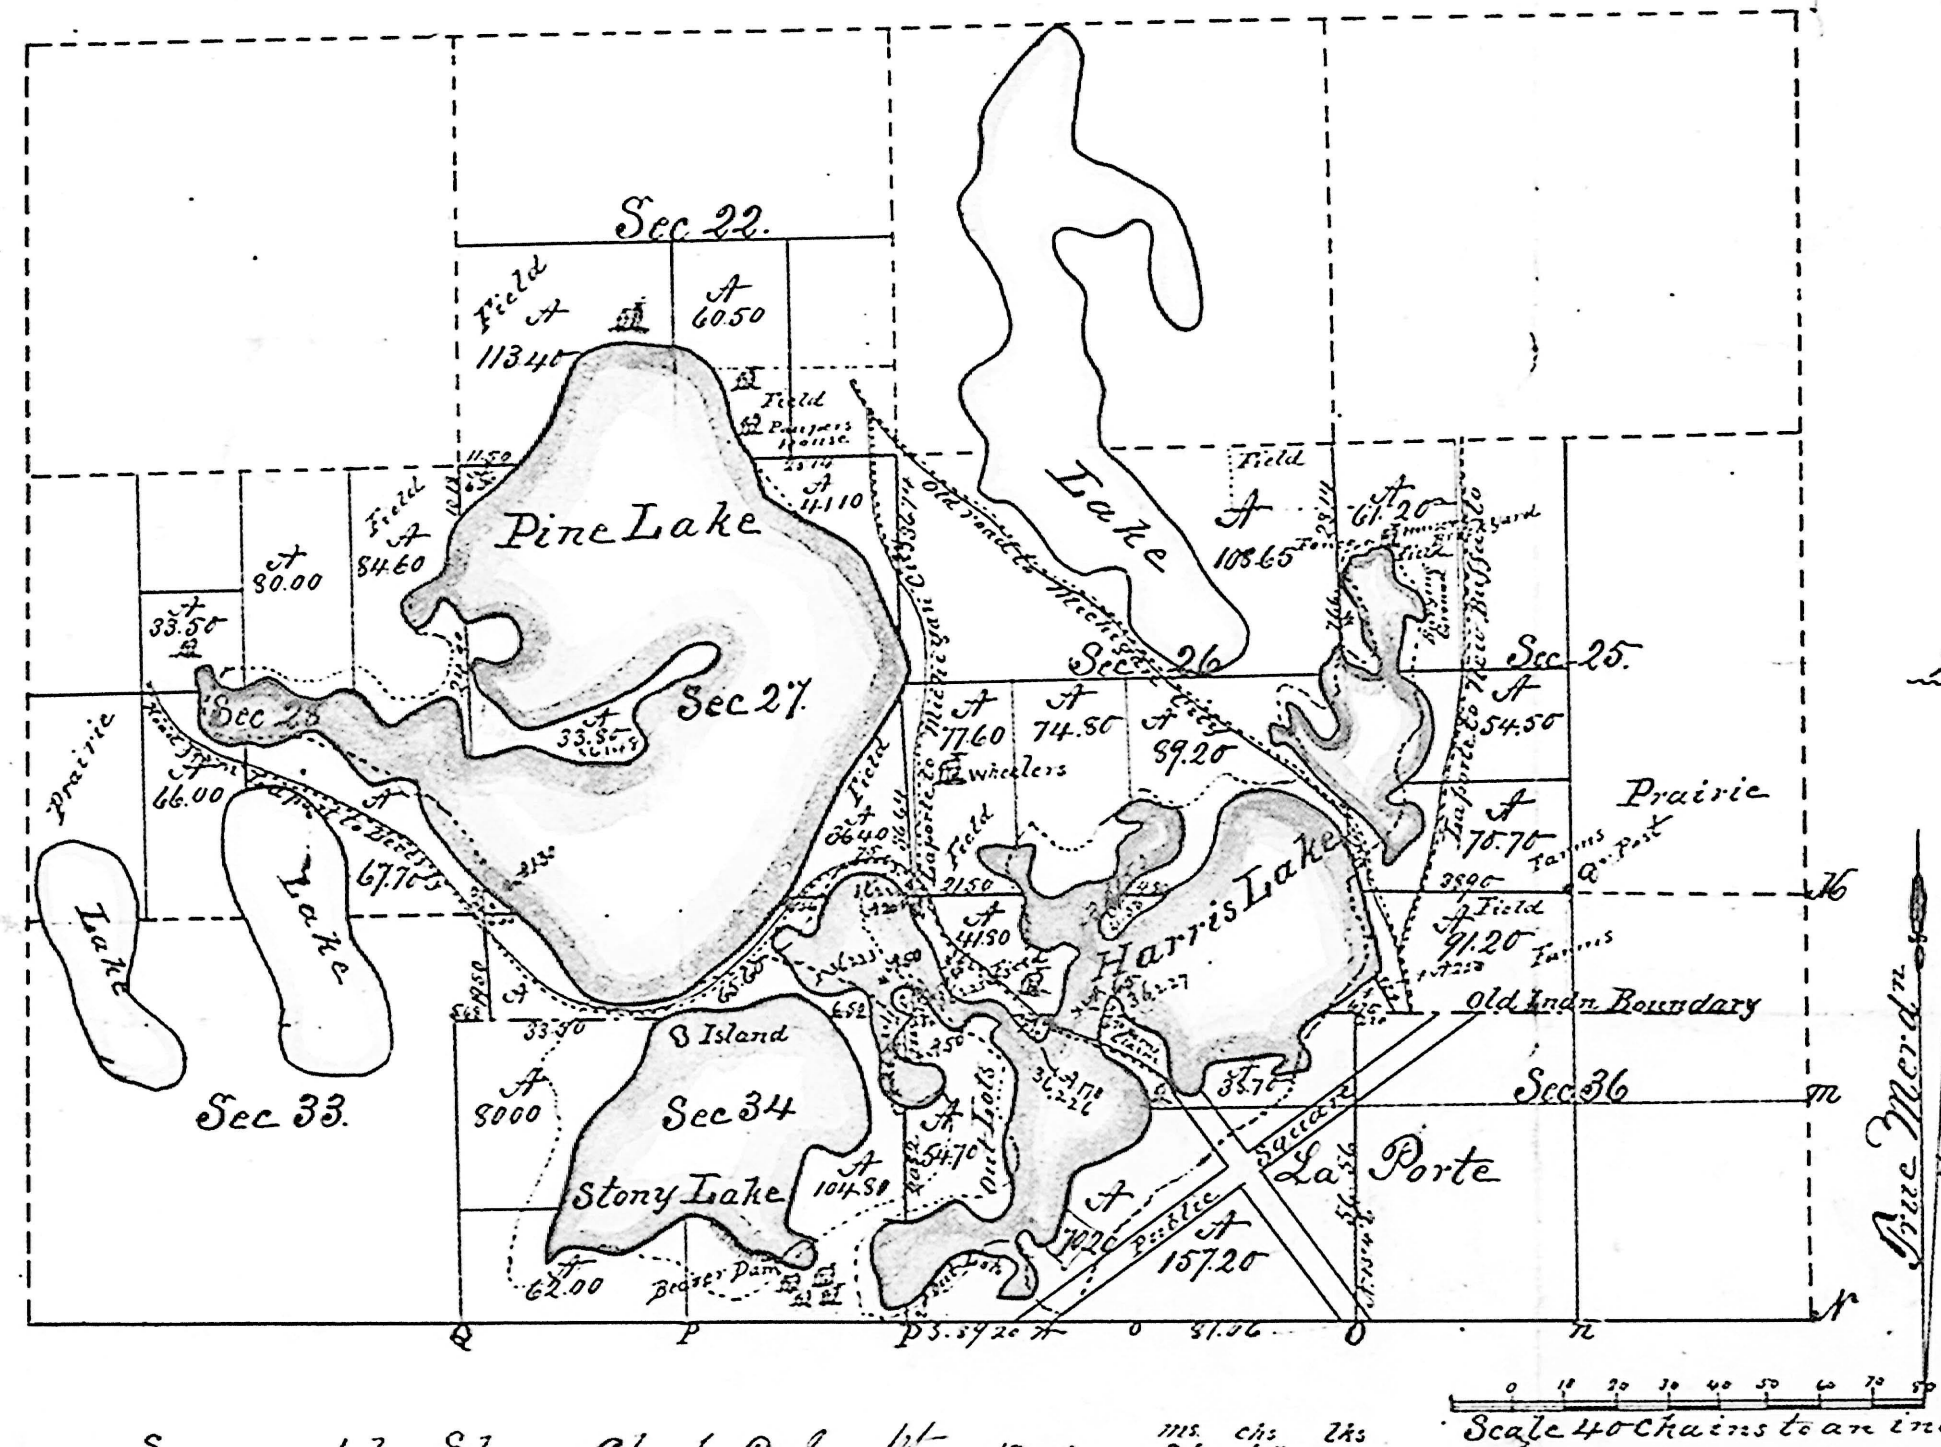

Note The dotted red lines represent the old boundaries.

Surveyed by Elam Clark D. S. 1st of 1847 ms. chs. 26. 65. 96

The above diagram of a part of N 37 N. R 3 W of the 2nd P. Meridian Indiana is strictly conformable to the field notes of the survey there of, on file in this Office, which have been examined and approved, the said survey having been made in accordance with instructions from the Commissioner of the General Land Office of 29th August 1846.

Surveyor General's Office
Detroit April 27th 1847.

Lucius Lyon
Surf. Genl.

Department of the Interior
General Land Office
August 14th 1871.

I hereby certify that this is a correct copy of the plat of Township No 37 N. R No 3 W 2nd Mer Ind. on file in this Office.

Wells Edmund
Commissioner

Township N^o XXXVII north. Range N^o III west 2nd Mer.



111			60111111		
Sections	Acres	sq	Sections	Acres	sq
Sec 1	640		Ex. NE 26	107 1/2	15
2	640		W. 1/2 SE	113 3/4	35
3	640		Ex. SW	60 88	
4	640		W. 1/2 NE 27	40 83	
5	640		SE	32 75	
6	320		SW	68 86	
Ex. NW	80		Ex. NE 28	82 05	
W. 1/2 NW	79 03		W. 1/2	85 20	
Ex. SW	80		SW	160	
W. 1/2	77 09		S. 1/2 SE	36 10	
Ex. NW	80		Ex. SW	61 50	
W. 1/2 SW	77 84		W. 1/2	57 70	
Ex. SW	80		Sec 29	640	
W. 1/2	81 28		Ex. 30	320	
Sec 8	640		Ex. NW	80	
9	640		W. 1/2	98 73	
10	640		Ex. SW	80	
11	640		W. 1/2	98 99	
12	640		Ex. 31	100 60	
13	640		W. 1/2	116 85	
14	640		Ex. 32	100 28	
15	640		W. 1/2	101 09	
16	640		Ex. NW	80	
17	640		W. 1/2	46 05	
18	320		Sec 33	640	
Ex. NW	80		W. 1/2	96 6	
W. 1/2 NW	84 45		Sec 34	60 90	
Ex. SW	80		W. 1/2	25 66	
W. 1/2	87 35		Ex. 36	98 33	
Ex. NW	320		W. 1/2	92 24	
W. 1/2 NW	80			3115 64	
Ex. NW	90 50			1575 629	
W. 1/2 NW	80				
Ex. NW	93 90				
Sec 20	640				
21	640				
Ex. NW	320				
W. 1/2 NW	80				
Ex. NW	69 90				
W. 1/2 NW	112 70				
Ex. NW	80				
W. 1/2 NW	72 00				
Ex. NW	100 64				
W. 1/2 NW	80				
Ex. NW	85 10				
W. 1/2 NW	70 00				
Ex. NW	640				
W. 1/2 NW	320				
Ex. NW	80				
W. 1/2 NW	57 10				
Ex. NW	53 56				
W. 1/2 NW	63 95				
Ex. NW	1575 629				

Surveyed in December 1829 by Thomas Henderson S. S.

A true copy of the original plat filed in this office

Surveyor General's Office

13th July 1830

Offered for Sale Nov. 1830

Min. Sytle S. S.